


STAMP PIN APL 256

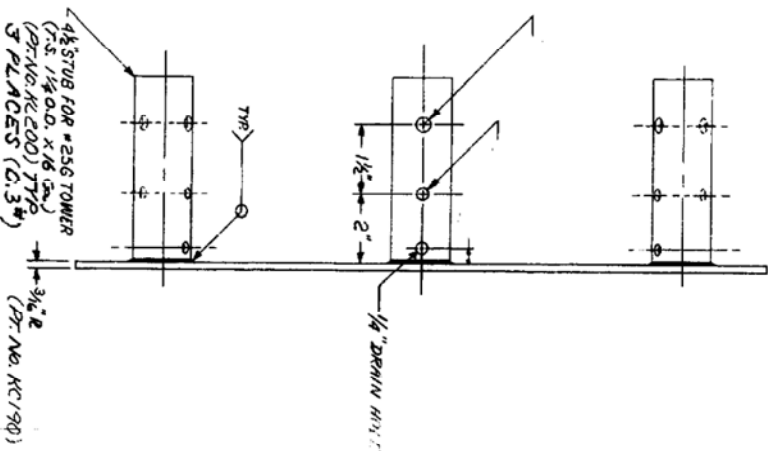

DETAILED AS BUILT

NO.	REVISIONS	DATE	BY
R1	ADD WTS	6-27-80	JES
R2	ADDED PT. NOS.	10-21-77	RLH
R3	ADD STUB SIZE	4-29-75	WBL

ROHN MANUFACTURING

TITLE
 BEACON PLATE FABRICATION FOR No. 256 TOWER - STAMP PIN APL 256

DESIGNED BY	DATE	CHECKED BY	DATE
R.D.B.	1-14-75	W.B.L.	7-16-75
APPROVED BY	DATE	TOLERANCES	DWG. NO.
W.B.L.	7-17-75	± .0005	C-750028